


PROJ No. 69962
 AIP No. 3-02-0297-01

TIDE DATA
 CH1 = 20.0 (EST)
 MHW = 14.5
 MTL = 8.2
 MLLW = 0.0
 ELT = -4.5 (EST.)

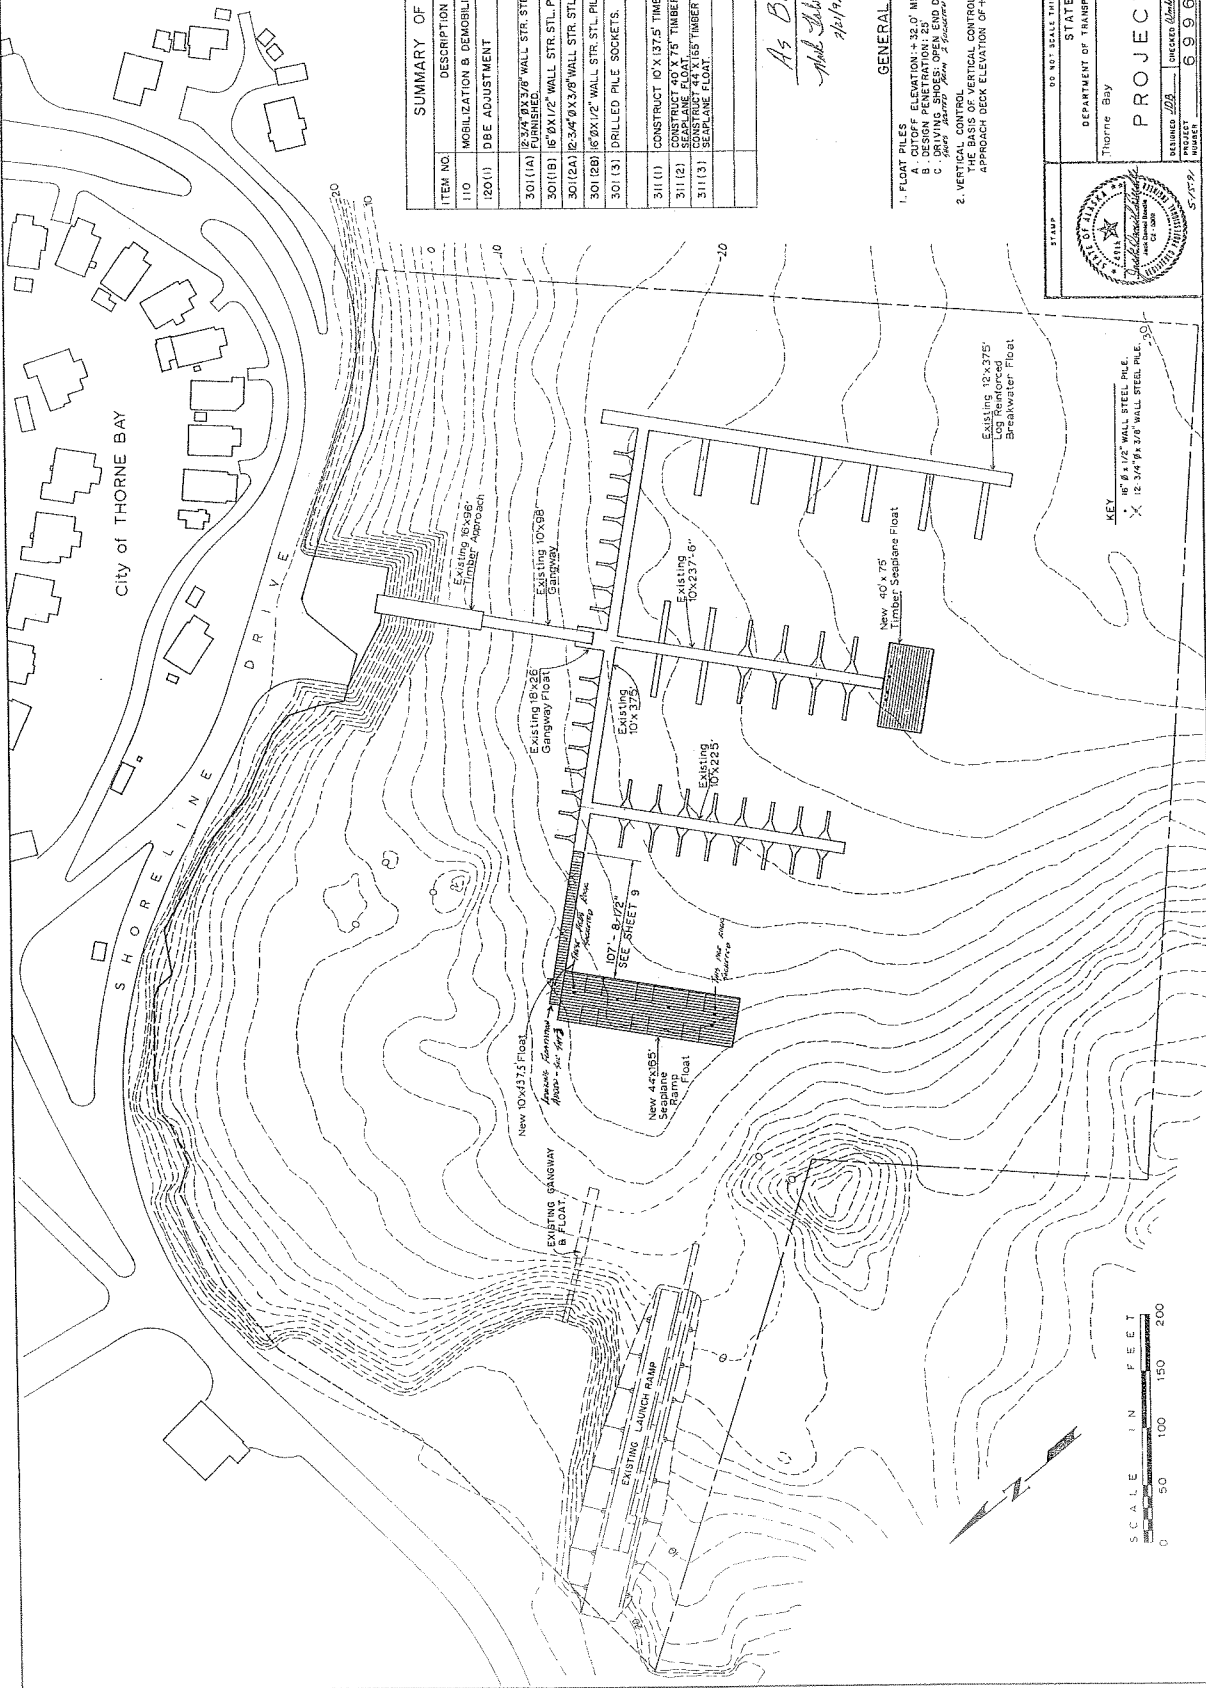

SUMMARY OF QUANTITIES			
ITEM NO.	DESCRIPTION	UNIT	QUANTITY
110	MOBILIZATION & DEMOBILIZATION	L.S. ALL REQ'D.	
120(1)	DBE ADJUSTMENT	C.S. ALL REQ'D.	
30(1A)	12 3/4" X 3 3/8" WALL STR. STEEL PILES	L.F.	247.93
30(1B)	16" X 4 1/2" WALL STR. STL. PILES, FURN.	L.F.	666.99
30(1A)	12 3/4" X 3 3/8" WALL STR. STL. PILES, DRIVEN	E.A.	3
30(1B)	16" X 4 1/2" WALL STR. STL. PILES, DRIVEN	E.A.	9
30(13)	DRILLED PILE SOCKETS	E.A.	23
31(1)	CONSTRUCT 10' X 137.5' TIMBER FLOAT.	L.S. ALL REQ'D.	
31(2)	SEAPLANE FLOAT	L.S. ALL REQ'D.	
31(3)	CONSTRUCT 44' X 165' TIMBER RAMPED SEAPLANE FLOAT	L.S. ALL REQ'D.	

As Built
 M. Johnson
 2/1/82

GENERAL NOTES
 1. FLOAT PILES
 A. CUTOFF ELEVATION +32.0' MLLW.
 B. DRIVING SHOES OPEN END DRIVING SHOES ALL PILES.
 C. DRIVING SHOES OPEN END DRIVING SHOES ALL PILES.
 2. VERTICAL CONTROL
 APPROACH DECK ELEVATION OF +24.0' MLLW.

STATE OF ALASKA
 DEPARTMENT OF TRANSPORTATION AND PUBLIC FACILITIES
 Thorne Bay

PROJECT LAYOUT

DATE: 6/9/82
 SHEET: 2 OF 13